


# Las Olas Centre II

350 East Las Olas Boulevard, Fort Lauderdale, FL 33301

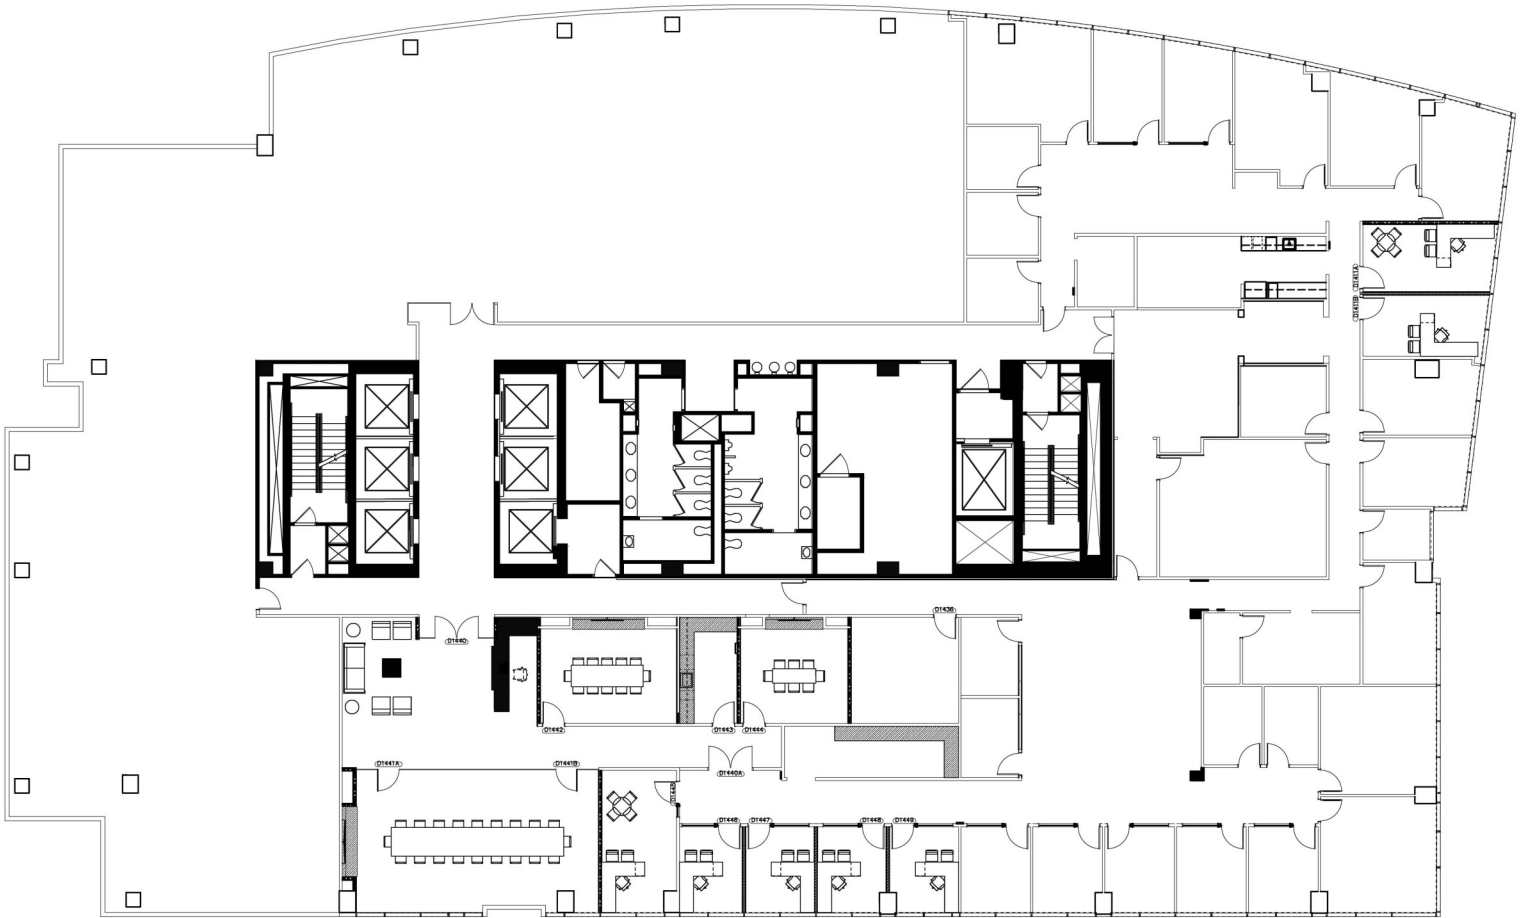

**Suite 1420 -13,801 SF**

**As Built**

[VTS Market Listing](#)

FOR LEASING INFORMATION:

Timothy J. Talbot | [ttalbot@comreal.com](mailto:ttalbot@comreal.com)

Andrew Ackerman | [aackerman@comreal.com](mailto:aackerman@comreal.com)

**954.385.0000**

