


# Bank of America Plaza

1776 North Pine Island Road Plantation, FL 33322

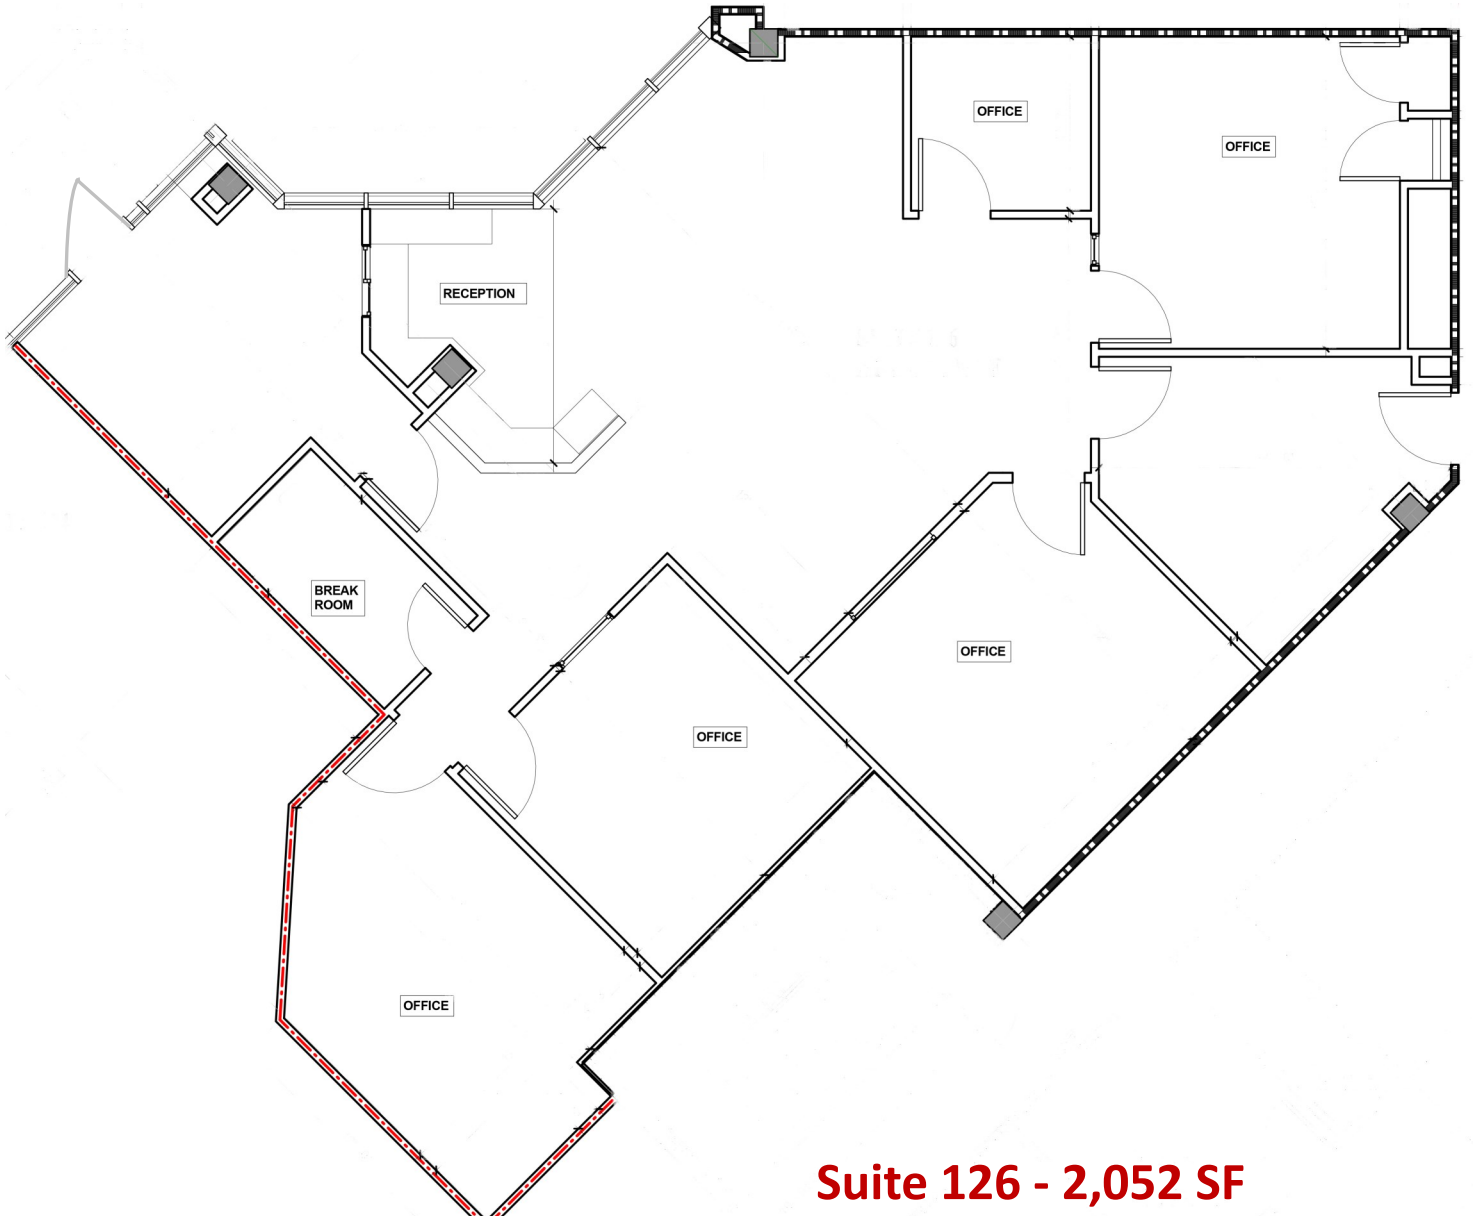

**Suite 126 - 2,052 SF**

**As Built**

FOR LEASING INFORMATION:

Andrew Ackerman | [aackerman@comreal.com](mailto:aackerman@comreal.com)

**954.385.0000**



# Bank of America Plaza

1776 North Pine Island Road Plantation, FL 33322



**Suite 126 - 2,052 SF**

**Medical Spec Plan**

FOR LEASING INFORMATION:

Andrew Ackerman | [aackerman@comreal.com](mailto:aackerman@comreal.com)

**954.385.0000**

